


EARTHWORKS AS CONSTRUCTED PLAN

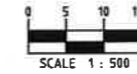

LEGEND	
	EXTENT OF FILL
+ 10.859	SURFACE SPOT LEVELS
	CONTOUR MAJOR
	CONTOUR MINOR
	STAGE 3 & 4 BOUNDARY

WORKS AS CONSTRUCTED

IT IS CERTIFIED THAT THE LOCATION, LEVELS AND DIMENSIONS OF THE INFRASTRUCTURE SHOWN HEREIN ARE A TRUE REPRESENTATION OF THE CONSTRUCTED WORKS AND THAT THE AS-CONSTRUCTED SURVEY WAS PERFORMED TO THE PRESCRIBED ACCURACY STANDARDS.

Signature _____ Date _____
(Licensed Surveyor / Director)

Signature _____
(Director)

COTTRELL CAMERON & STEEN SURVEYS Pty. Ltd.

WORKS AS CONSTRUCTED

IT IS CERTIFIED THAT WORKS HEREIN HAVE BEEN CONSTRUCTED TO LOCAL GOVERNMENT STANDARDS, RELEVANT APPROVED SPECIFICATIONS AND THE OPERATIONAL WORKS APPROVAL. THE AS-CONSTRUCTED DRAWINGS FOR THESE WORKS CONSTITUTES A TRUE AND CORRECT RECORD OF THE WORKS CONSTRUCTED AND COMPLIES WITH THE DESIGN INTENT.

Signature RPEQ No. 6382
ANDREW PEZZUTTI

Date of Practical Completion 8/8/14

FOR AND ON BEHALF OF
LAMBERT & REHBEIN (SEQ) PTY. LTD.

PREVIOUS RCC App. Ref. EC005056.3&4
CURRENT RCC App. Ref. ROL005650

Associated Consultants: COTTRELL CAMERON & STEEN SURVEYS Pty Ltd Middle St (Cnr Waterloo St) Phone: (07) 3286 5322 Cleveland Qld 4163 Fax: (07) 3286 2561	R.P.D. Lot 2 R.P. 98600 Parish of REDLAND County of STANLEY LEVEL DATUM A.H.D. DERIVED P.S.M. 97804 R.I. 11.888			LAMBERT & REHBEIN ENGINEERS • MANAGERS • SCIENTISTS CBD HOUSE LEVEL 3, 120 WICKHAM STREET FORTITUDE VALLEY QLD 4006 P.O. BOX 112 FORTITUDE VALLEY QLD 4006 A.C.N. 010 451 902 TELEPHONE (07) 3250 9000 FACSIMILE (07) 3250 9001 EMAIL mail@lar.net.au	Project: PROPOSED AFFORDABLE HOUSING 41 BANKSWOOD DRIVE REDLAND BAY - STAGE 4	Client: Harridan Pty Ltd	
		No.	Date		By	Amendment	Checked

THIS DESIGN AND DRAWING IS COPYRIGHT. NO PART OF THIS DRAWING MAY BE REPRODUCED, STORED IN A RETRIEVAL SYSTEM OR TRANSMITTED IN ANY FORM WITHOUT THE WRITTEN PERMISSION OF LAMBERT AND REHBEIN PTY LTD