


**SEWERAGE RETICULATION LAYOUT PLAN**

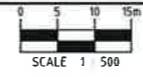

**WORKS AS CONSTRUCTED**

IT IS CERTIFIED THAT THE LOCATION, LEVELS AND DIMENSIONS OF THE INFRASTRUCTURE SHOWN HEREIN ARE A TRUE REPRESENTATION OF THE CONSTRUCTED WORKS AND THAT THE AS-CONSTRUCTED SURVEY WAS PERFORMED TO THE PRESCRIBED ACCURACY STANDARDS.

Signature: *[Signature]* Date: 7/18/14  
 Signature: *[Signature]*  
 COTTRELL CAMERON & STEEN SURVEYS Pty. Ltd.

**WORKS AS CONSTRUCTED**

IT IS CERTIFIED THAT WORKS HEREIN HAVE BEEN CONSTRUCTED TO LOCAL GOVERNMENT STANDARDS, RELEVANT APPROVED SPECIFICATIONS AND THE OPERATIONAL WORKS APPROVAL. THE AS-CONSTRUCTED DRAWINGS FOR THESE WORKS CONSTITUTES A TRUE AND CORRECT RECORD OF THE WORKS CONSTRUCTED AND COMPLIES WITH THE DESIGN INTENT.

Signature: *[Signature]* RPEQ No. 6382  
 ANDREW PEZZUTTI  
 Date of Practical Completion: 8/8/14  
 FOR AND ON BEHALF OF  
 LAMBERT & REHBEIN (SRA) PTY. LTD.

PREVIOUS RCC App. Ref. EC005056.3&4  
 CURRENT RCC App. Ref. ROL005650

Associated Consultants: <b>COTTRELL CAMERON &amp; STEEN SURVEYS Pty Ltd</b> Middle St (Cnr Waterloo St) Phone: (07) 3286 5322 Cleveland Fax: (07) 3286 2561 Qld 4163	<b>R.P.D.</b> Lot 2 R.P. 98600 Parish of REDLAND County of STANLEY <b>LEVEL DATUM</b> A.H.D. DERIVED P.S.M. 97804 R.L. 11.556	<b>LAMBERT &amp; REHBEIN</b> ENGINEERS • MANAGERS • SCIENTISTS CBD HOUSE LEVEL 3, 120 WICKHAM STREET FORTITUDE VALLEY QLD 4006 P.O. BOX 112 FORTITUDE VALLEY QLD 4006 A.C.N. 010 451 902 TELEPHONE (07) 3250 9000 FACSIMILE (07) 3250 9001 EMAIL mail@lar.net.au		Project: PROPOSED AFFORDABLE HOUSING 41 BANKSWOOD DRIVE REDLAND BAY - STAGE 4	Client: <b>Harridan Pty Ltd</b>																								
		<table border="1"> <thead> <tr> <th>No.</th> <th>Date</th> <th>By</th> <th>Amendment</th> <th>Checked</th> </tr> </thead> <tbody> <tr> <td>B</td> <td>25.08.14</td> <td>S.G.</td> <td>AS CONSTRUCTED - MINOR AMENDMENTS</td> <td></td> </tr> <tr> <td>A</td> <td>15.10.13</td> <td>S.G.</td> <td>AS CONSTRUCTED</td> <td></td> </tr> </tbody> </table>	No.	Date	By	Amendment	Checked	B	25.08.14	S.G.	AS CONSTRUCTED - MINOR AMENDMENTS		A	15.10.13	S.G.	AS CONSTRUCTED		Title: SEWERAGE RETICULATION AS CONSTRUCTED PLAN MAIN, STRUCTURE & HC INFO	<table border="1"> <tr> <td>Draftsperson: SG</td> <td>Checked: AP</td> <td>Sheet Size: A1</td> <td>Drawing No.:</td> </tr> <tr> <td>Designer: SG</td> <td>Approved: A. Pezzutti RPEQ No: 6382</td> <td></td> <td>B02553-C411</td> </tr> <tr> <td>Scale: AS SHOWN</td> <td>Date: 18.10.13</td> <td></td> <td></td> </tr> </table>	Draftsperson: SG	Checked: AP	Sheet Size: A1	Drawing No.:	Designer: SG	Approved: A. Pezzutti RPEQ No: 6382		B02553-C411	Scale: AS SHOWN	Date: 18.10.13
No.	Date	By	Amendment	Checked																									
B	25.08.14	S.G.	AS CONSTRUCTED - MINOR AMENDMENTS																										
A	15.10.13	S.G.	AS CONSTRUCTED																										
Draftsperson: SG	Checked: AP	Sheet Size: A1	Drawing No.:																										
Designer: SG	Approved: A. Pezzutti RPEQ No: 6382		B02553-C411																										
Scale: AS SHOWN	Date: 18.10.13																												

THIS DESIGN AND DRAWING IS COPYRIGHT. NO PART OF THIS DRAWING MAY BE REPRODUCED, STORED IN A RETRIEVAL SYSTEM OR TRANSMITTED IN ANY FORM WITHOUT THE WRITTEN PERMISSION OF LAMBERT & REHBEIN PTY LTD.