


**SEWERAGE RETICULATION LAYOUT PLAN**

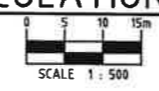

- NOTES**
1. ALL SEWER PIPES ARE 150Ø uPVC CLASS 'SN8' U.N.O.
  2. ALL SEWER PROPERTY CONNECTIONS ARE 100Ø uPVC CLASS 'SN8' U.N.O.

**LEGEND**

- AS CONSTRUCTED SEWERAGE LINE AND MANHOLE
- AS CONSTRUCTED MANHOLE NUMBER
- EXISTING STAGE 1 MANHOLE
- STAGE 4 BOUNDARY

**WORKS AS CONSTRUCTED**

IT IS CERTIFIED THAT THE LOCATION, LEVELS AND DIMENSIONS OF THE INFRASTRUCTURE SHOWN HEREIN ARE A TRUE REPRESENTATION OF THE CONSTRUCTED WORKS AND THAT THE AS-CONSTRUCTED SURVEY WAS PERFORMED TO THE PRESCRIBED ACCURACY STANDARDS.

Signature \_\_\_\_\_ Date \_\_\_\_\_  
(Licensed Surveyor / Director)

Signature \_\_\_\_\_  
(Director)

COTTRELL CAMERON & STEEN SURVEYS Pty. Ltd.

**WORKS AS CONSTRUCTED**

IT IS CERTIFIED THAT WORKS HEREIN HAVE BEEN CONSTRUCTED TO LOCAL GOVERNMENT STANDARDS, RELEVANT APPROVED SPECIFICATIONS AND THE OPERATIONAL WORKS APPROVAL. THE AS-CONSTRUCTED DRAWINGS FOR THESE WORKS CONSTITUTE A TRUE AND CORRECT RECORD OF THE WORKS CONSTRUCTED AND COMPLIES WITH THE DESIGN INTENT.

Signature RPEQ No. 6382  
ANDREW PEZZUTTI

Date of Practical Completion 8/8/14

FOR AND ON BEHALF OF  
LAMBERT & REHBEIN (SDQ) PTY. LTD.

Associated Consultants:  
COTTRELL CAMERON & STEEN SURVEYS Pty Ltd  
Middle St (Cnr Waterloo St) Phone: (07) 3286 5322  
Cleveland Qld 4163 Fax: (07) 3286 2561

**R.P.D.**  
Lot 2  
R.P. 98600  
Parish of REDLAND  
County of STANLEY  
**LEVEL DATUM**  
A.H.D. DERIVED  
P.S.M. 97804  
R.L. 11.656

No.	Date	By	Amendment	Checked
A	15.10.13	S.G.	AS CONSTRUCTED	

**LAMBERT & REHBEIN**  
ENGINEERS • MANAGERS • SCIENTISTS

CBD HOUSE  
LEVEL 3, 120 WICKHAM STREET  
FORTITUDE VALLEY QLD 4006  
P.O. BOX 112 FORTITUDE VALLEY QLD 4006  
A.C.N. 010 451 902

TELEPHONE (07) 3250 9800  
FACSIMILE (07) 3250 9001  
EMAIL mail@lar.net.au

Project: PROPOSED AFFORDABLE HOUSING  
41 BANKSWOOD DRIVE  
REDLAND BAY - STAGE 4

Title: SEWERAGE RETICULATION  
AS CONSTRUCTED PLAN

Client: **Harridan Pty Ltd**

Draftsperson: SG	Checked: AP	Sheet Size A1	Drawing No. B02553-C410
Designer: SG	Approved: RPEQ No. 6382 A. Pezzutti	Scale: AS SHOWN	Date: 18.10.13

PREVIOUS RCC App. Ref. EC005056.3&4  
CURRENT RCC App. Ref. ROL005650

THIS DESIGN AND DRAWING IS COPYRIGHT. NO PART OF THIS DRAWING MAY BE REPRODUCED, STORED IN A RETRIEVAL SYSTEM OR TRANSMITTED IN ANY FORM WITHOUT THE WRITTEN PERMISSION OF LAMBERT AND REHBEIN PTY LTD.