


REFER ADJACENT LAYOUT FOR CONTINUATION

INSET

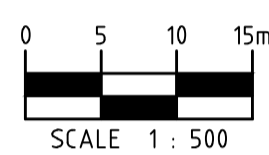

NOTES

1. ALL SEWER PIPES ARE 150Ø uPVC CLASS 'SN8' U.N.O.
2. ALL SEWER PROPERTY CONNECTIONS ARE 100Ø uPVC CLASS 'SN8' U.N.O.

LEGEND

- AS CONSTRUCTED SEWERAGE LINE AND MANHOLE
- AS CONSTRUCTED MANHOLE NUMBER
- EXISTING MANHOLE

WORKS AS CONSTRUCTED

IT IS CERTIFIED THAT THE LOCATION, LEVELS AND DIMENSIONS OF THE INFRASTRUCTURE SHOWN HEREIN ARE A TRUE REPRESENTATION OF THE CONSTRUCTED WORKS AND THAT THE AS-CONSTRUCTED SURVEY WAS PERFORMED TO THE PRESCRIBED ACCURACY STANDARDS.

Signature (Director) Date 16/3/2016

Signature (Director)

COTTRELL CAMERON & STEEN SURVEYS Pty. Ltd.

WORKS AS CONSTRUCTED

IT IS CERTIFIED THAT WORKS HEREIN HAVE BEEN CONSTRUCTED TO LOCAL GOVERNMENT STANDARDS, RELEVANT APPROVED SPECIFICATIONS AND THE OPERATIONAL WORKS APPROVAL. THE AS-CONSTRUCTED DRAWINGS FOR THESE WORKS CONSTITUTES A TRUE AND CORRECT RECORD OF THE WORKS CONSTRUCTED AND COMPLIES WITH THE DESIGN INTENT.


 
Signature RPEQ No. 15957

CRAIG HURLEY


Date of Practical Completion 19-10-2015

FOR AND ON BEHALF OF

LAMBERT & REHBEIN (SEQ) PTY. LTD.

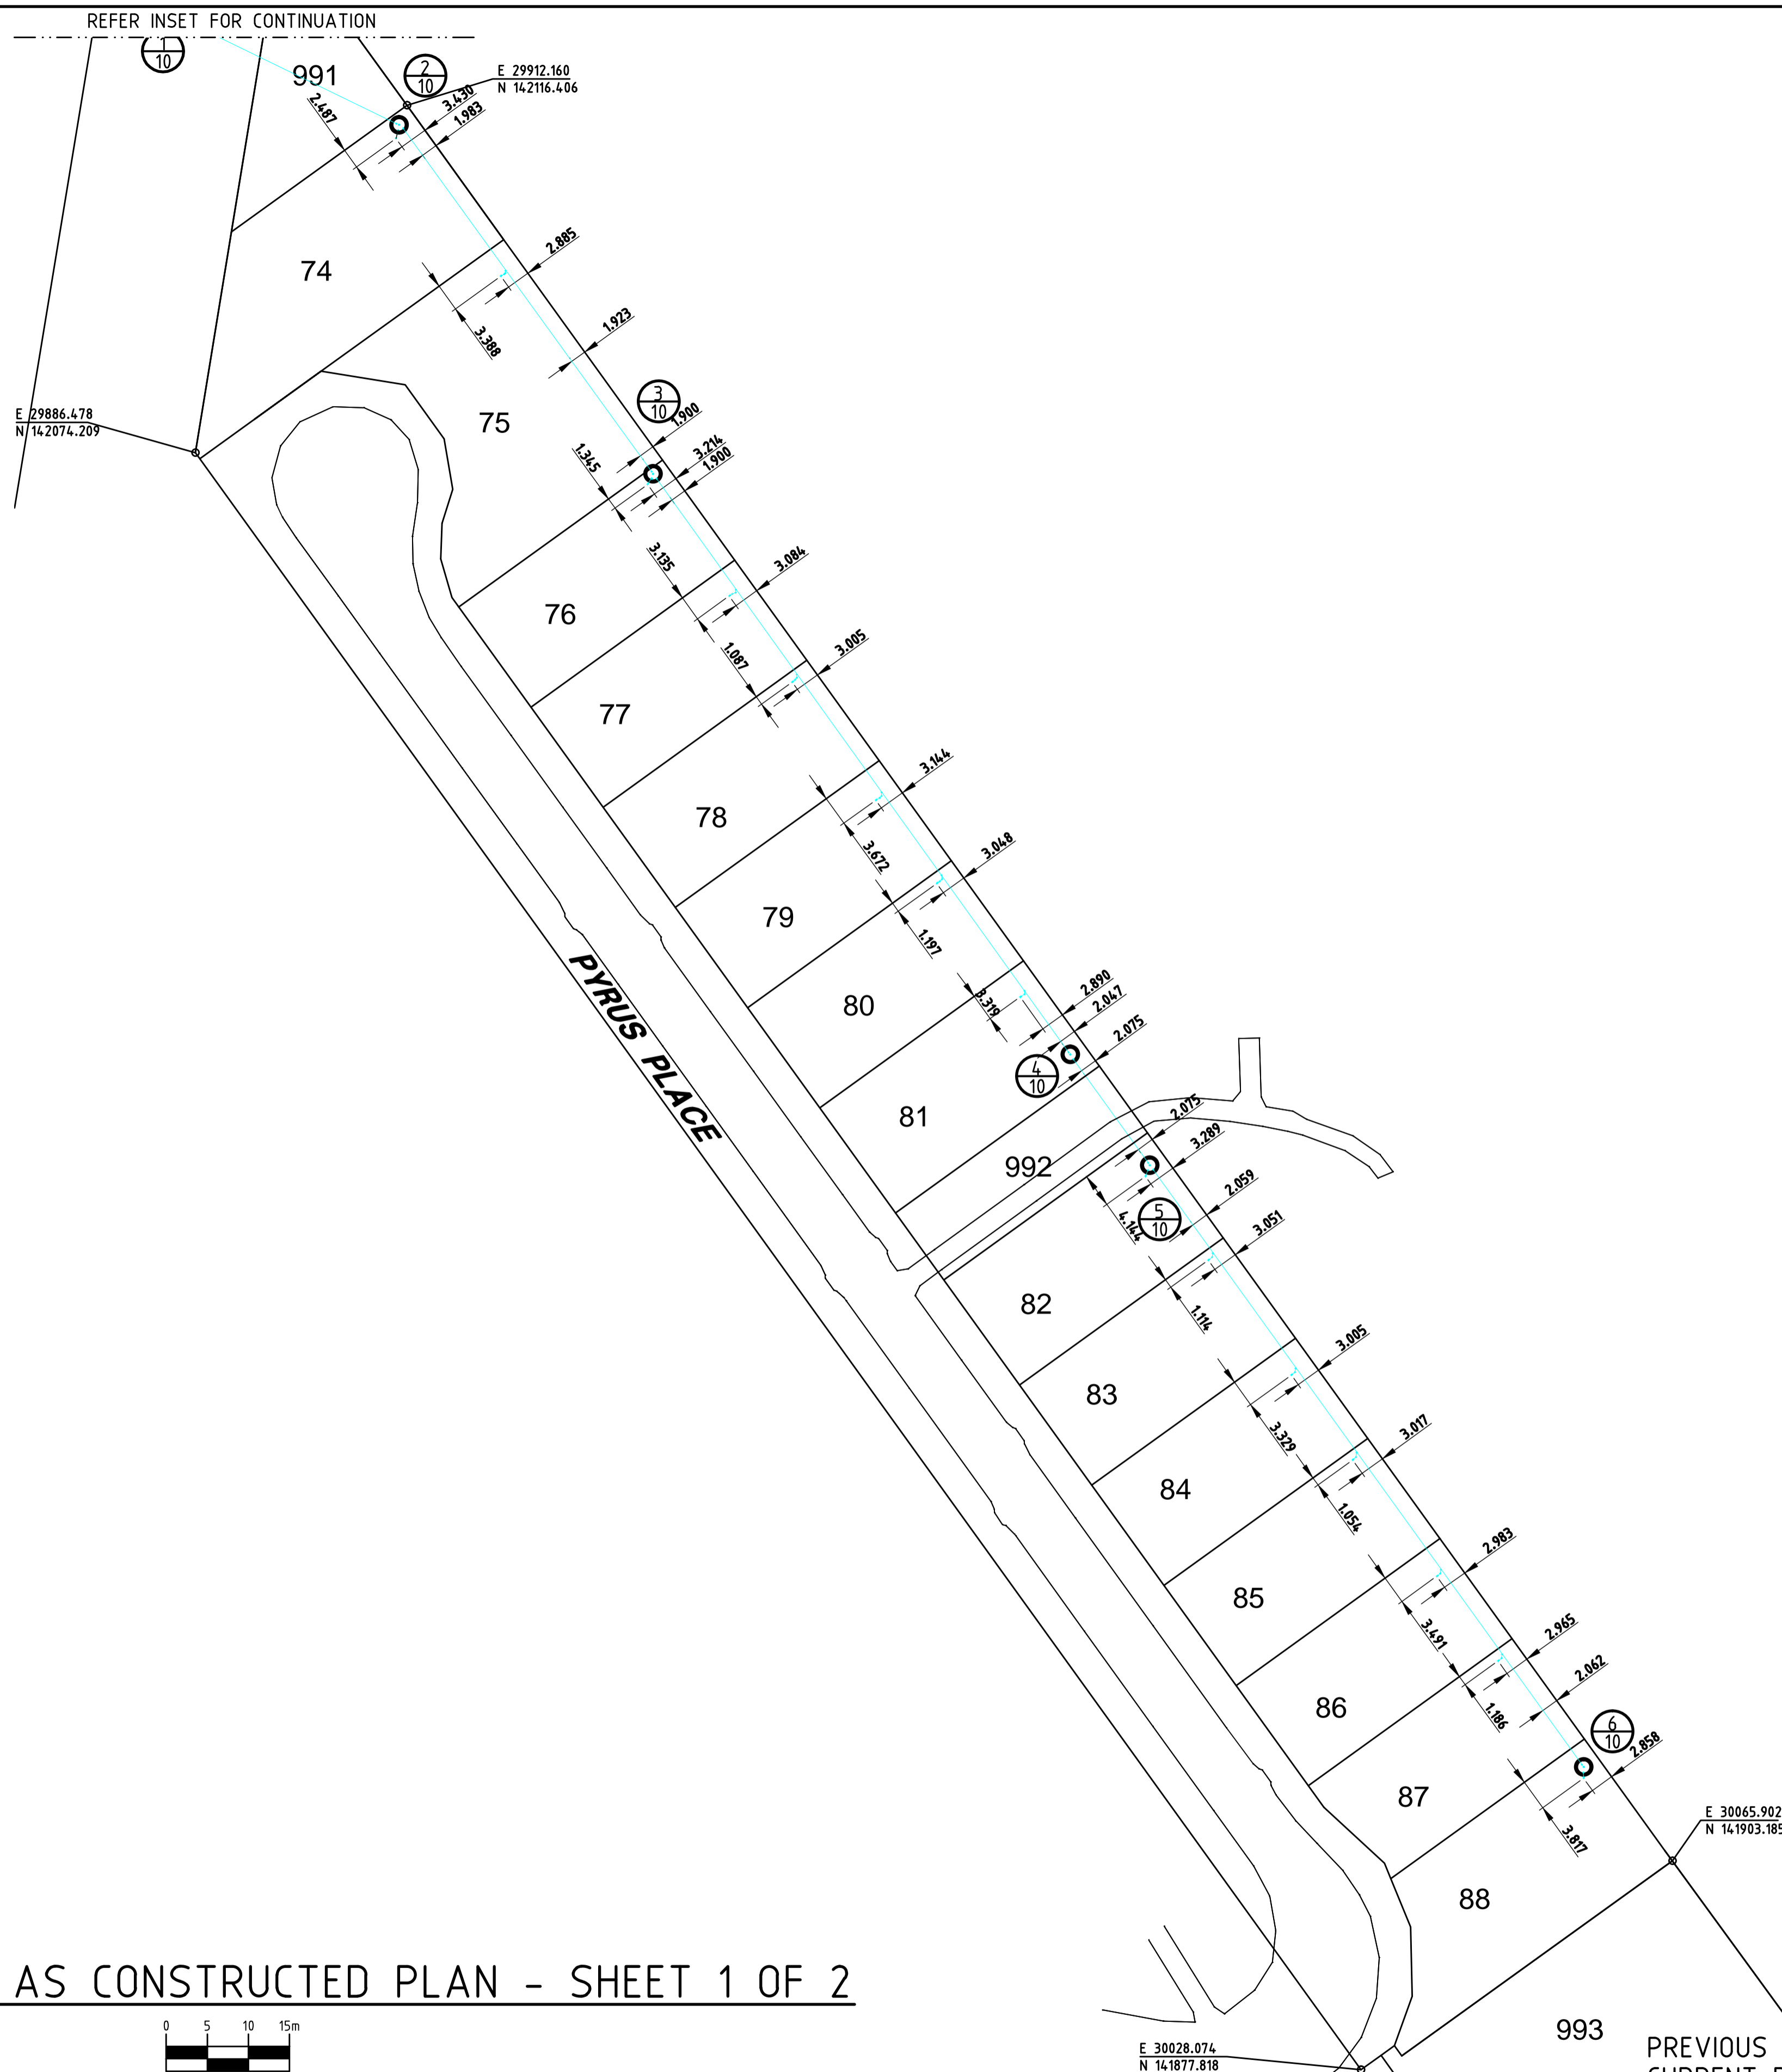

SEWERAGE AS CONSTRUCTED PLAN - SHEET 1 OF 2

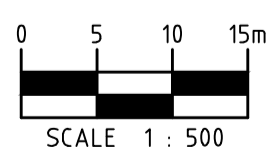

Associated Consultants:
COTTRELL CAMERON & STEEN SURVEYS Pty Ltd
107 MILES PLATING ROAD
EIGHT MILES PLAINS
Qld 4113

R.P.D.
Lot 2
R.P. 98600
Parish of REDLAND
County of STANLEY
LEVEL DATUM
A.H.D. DERIVED
P.S.M. 97804
R.L. 11.656

No.	Date	By	Amendment	Checked
B	15-03-16	R.T.	REVISED AS CONSTRUCTION ISSUE	
A	12-01-16	R.T.	AS CONSTRUCTED ISSUE	

LAMBERT & REHBEIN
ENGINEERS • MANAGERS • SCIENTISTS

CBD HOUSE
LEVEL 3, 120 WICKHAM STREET
FORTITUDE VALLEY QLD 4006
P.O. BOX 112 FORTITUDE VALLEY QLD 4006
A.C.N. 010 451 902

TELEPHONE (07) 3250 9000
FACSIMILE (07) 3250 9001
EMAIL mail@lar.net.au



Project: ~~PROPOSED~~ RESIDENTIAL SUBDIVISION
58-98 DONALD ROAD
REDLAND BAY - STAGE 5


Title: SEWERAGE AS CONSTRUCTED PLAN - SHEET 1 OF 2

Client: **Harridan Pty Ltd**

Draftsperson: R.T.
Checked: D.L.
Designer: R.T.
Approved: A. PEZZUTTI
RPEQ No: 6382
Scale: AS SHOWN
Date: DEC 2015


Sheet Size: A1
Drawing No.: B02553-C550
A B

RCC Ref: OPW001621
PREVIOUS RCC App. Ref. EC005056.5
CURRENT RCC App. Ref. ROL00564.7

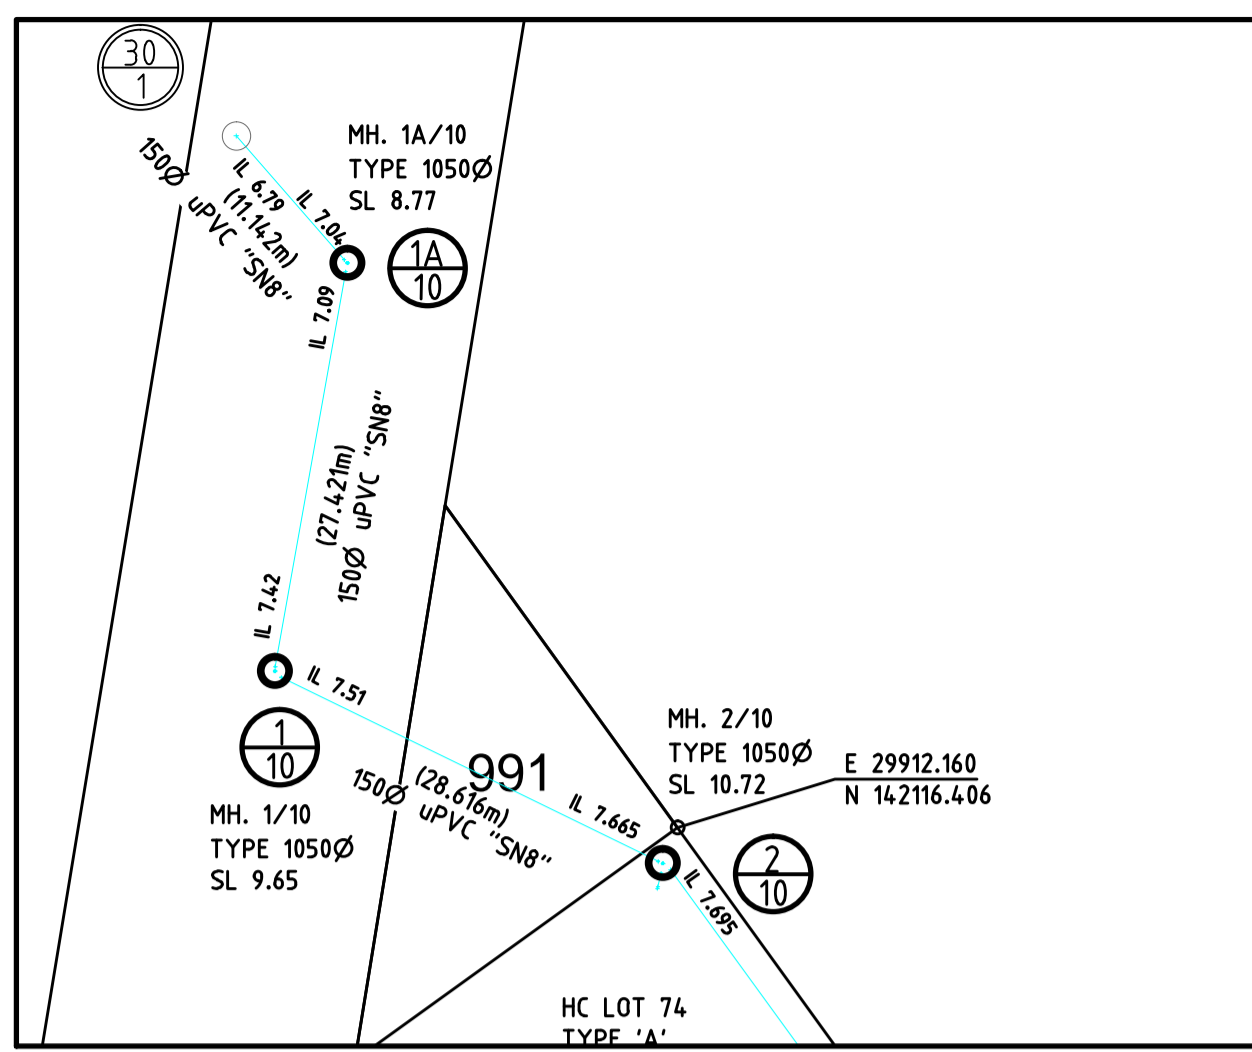

REFER ADJACENT LAYOUT FOR CONTINUATION

INSET

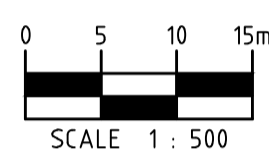

NOTES

1. ALL SEWER PIPES ARE 150Ø UPVC CLASS 'SN8' U.N.O.
2. ALL SEWER PROPERTY CONNECTIONS ARE 100Ø UPVC CLASS 'SN8' U.N.O.

LEGEND

- AS CONSTRUCTED SEWERAGE LINE AND MANHOLE
- AS CONSTRUCTED MANHOLE NUMBER
- EXISTING MANHOLE

WORKS AS CONSTRUCTED

IT IS CERTIFIED THAT THE LOCATION, LEVELS AND DIMENSIONS OF THE INFRASTRUCTURE SHOWN HEREIN ARE A TRUE REPRESENTATION OF THE CONSTRUCTED WORKS AND THAT THE AS-CONSTRUCTED SURVEY WAS PERFORMED TO THE PRESCRIBED ACCURACY STANDARDS.

Signature (Director) Date 16/3/2016

Signature (Director)

COTTRELL CAMERON & STEEN SURVEYS Pty. Ltd.

WORKS AS CONSTRUCTED

IT IS CERTIFIED THAT WORKS HEREIN HAVE BEEN CONSTRUCTED TO LOCAL GOVERNMENT STANDARDS, RELEVANT APPROVED SPECIFICATIONS AND THE OPERATIONAL WORKS APPROVAL. THE AS-CONSTRUCTED DRAWINGS FOR THESE WORKS CONSTITUTES A TRUE AND CORRECT RECORD OF THE WORKS CONSTRUCTED AND COMPLIES WITH THE DESIGN INTENT.

Signature RPEQ No. 15957



CRAIG HURLEY

Date of Practical Completion 19-10-2015

FOR AND ON BEHALF OF

LAMBERT & REHBEIN (SEQ) PTY. LTD.

SEWERAGE AS CONSTRUCTED PLAN - SHEET 2 OF 2

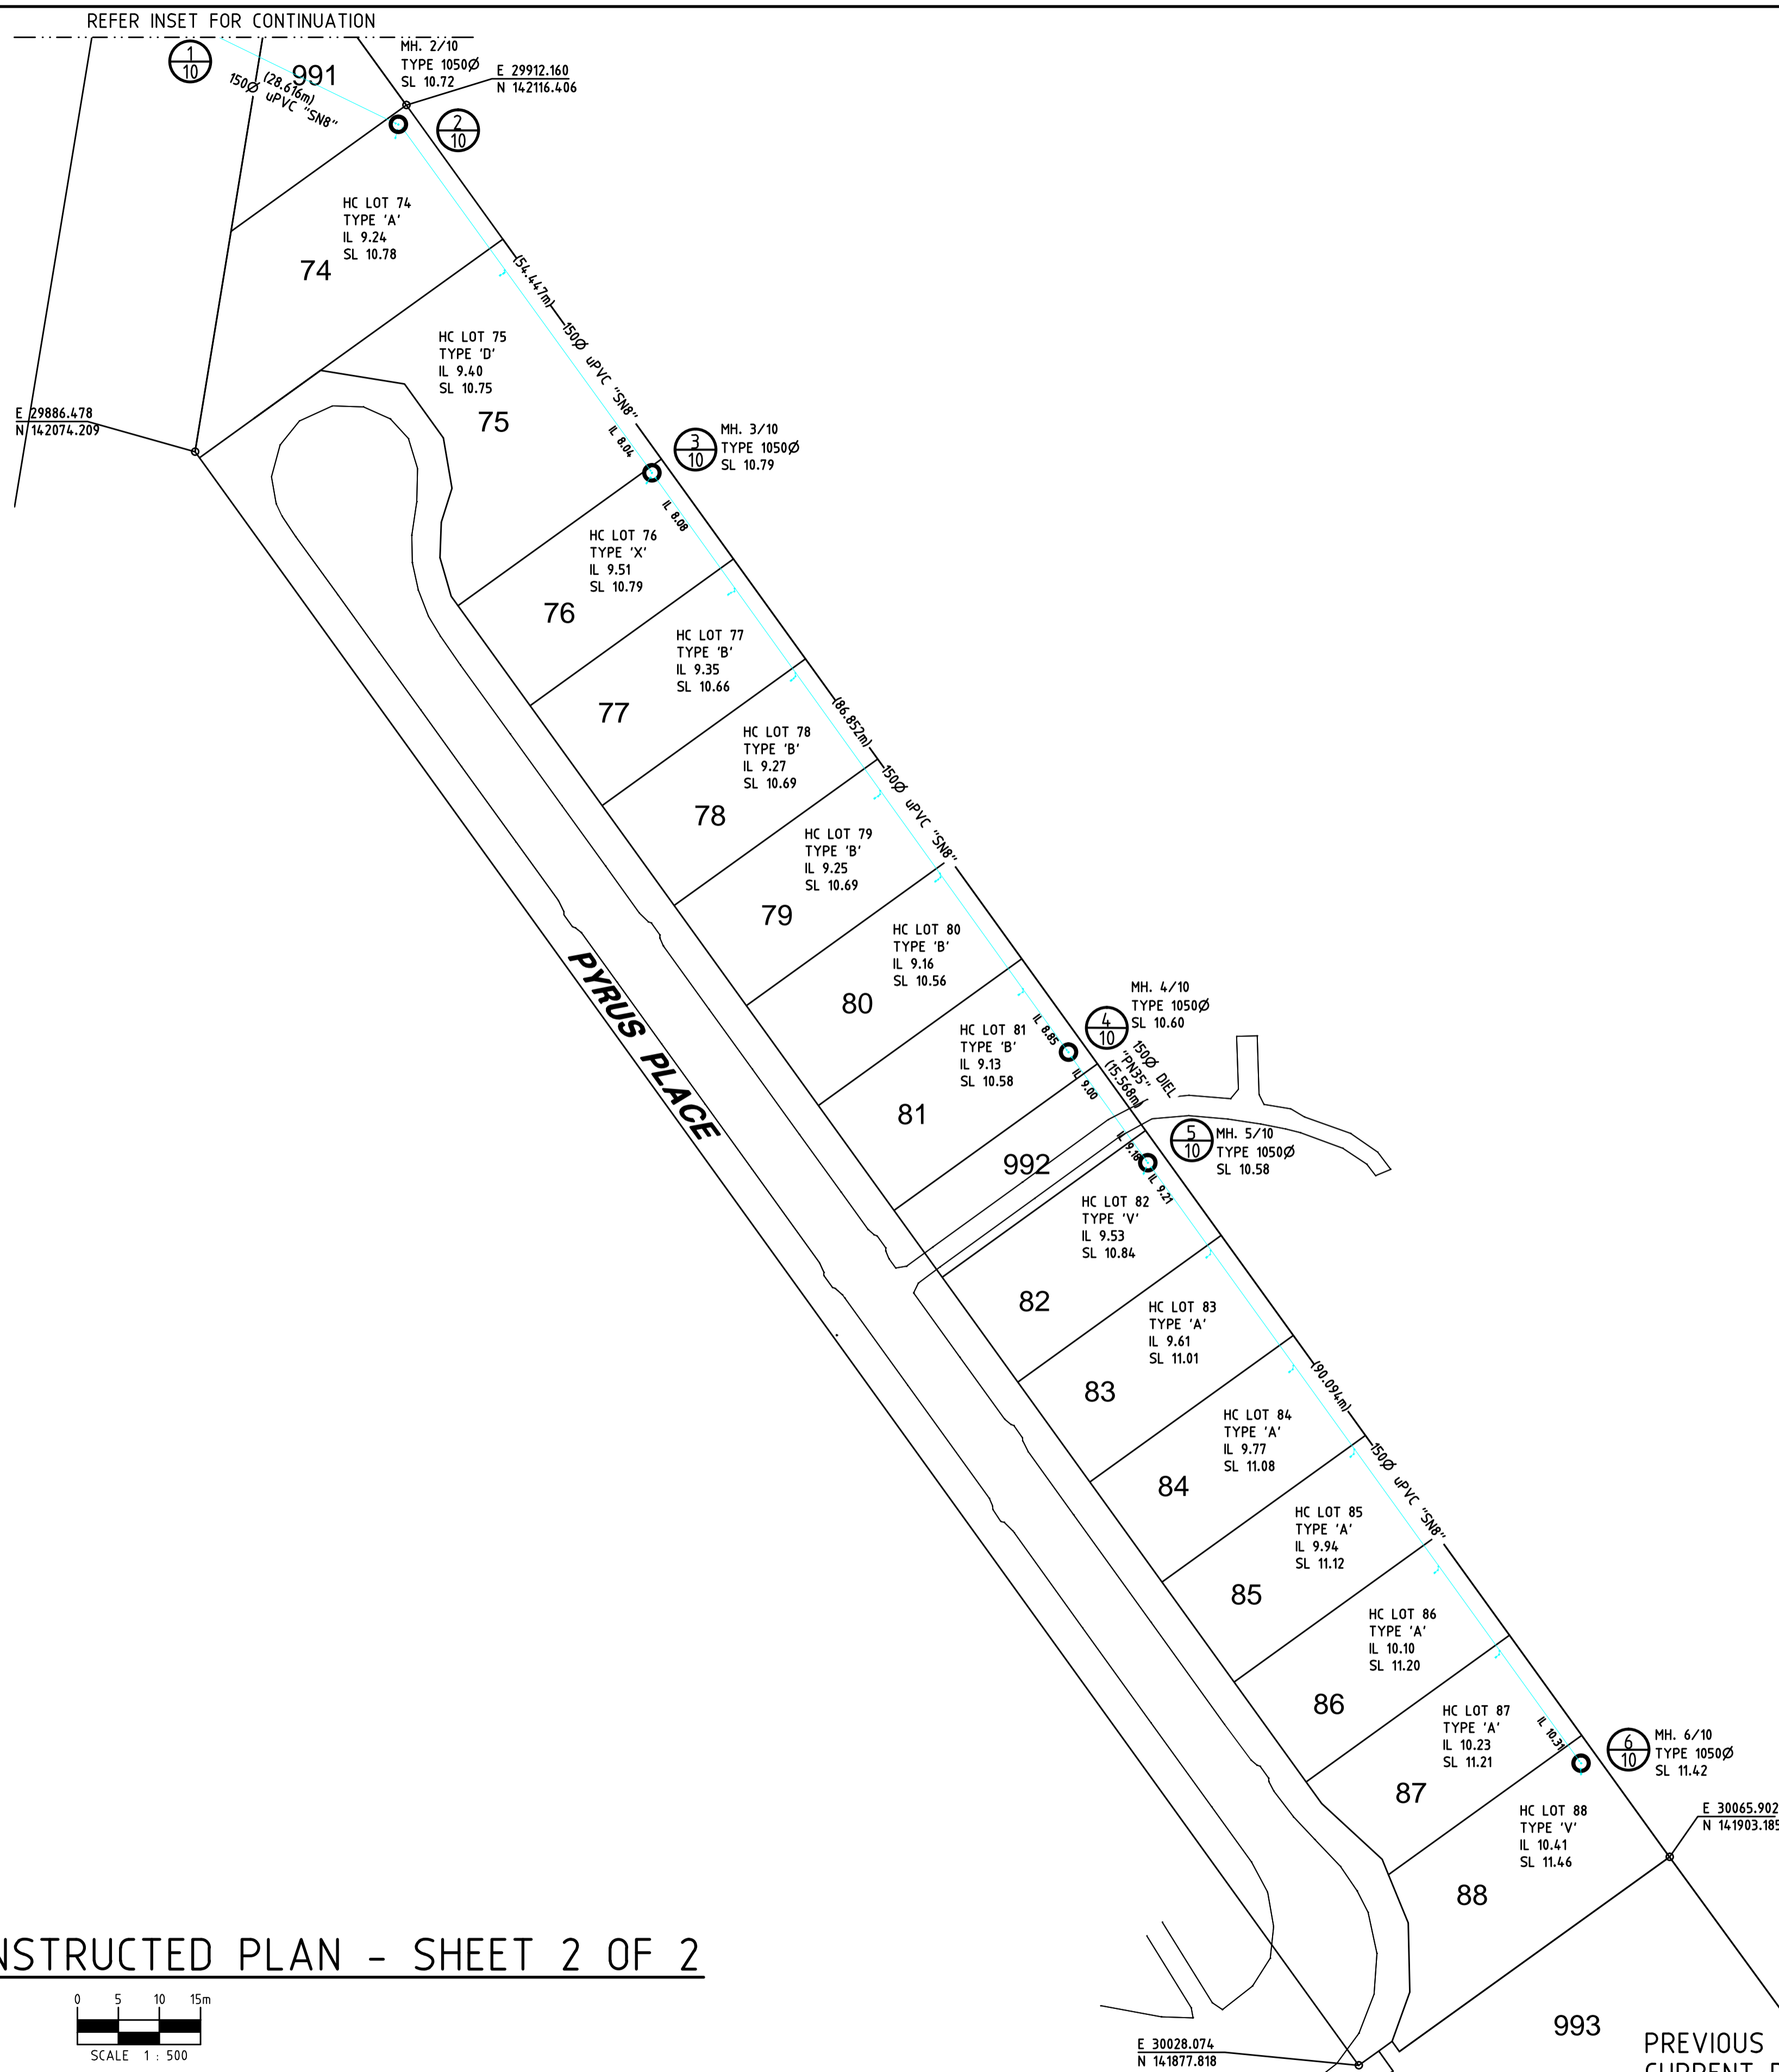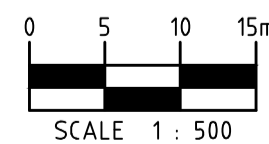

RCC Ref: OPW001621
PREVIOUS RCC App. Ref. EC005056.5
CURRENT RCC App. Ref. ROL005647

Associated Consultants:
COTTRELL CAMERON & STEEN SURVEYS Pty Ltd
107 MILES PLATING ROAD
EIGHT MILES PLAINS
Qld 4113
Phone: (07) 334 09700
Fax: (07) 3862 6210

R.P.D.
Lot 2
R.P. 98600
Parish of REDLAND
County of STANLEY
LEVEL DATUM
A.H.D. DERIVED
P.S.M. 97804
R.L. 11.656

No.	Date	By	Amendment	Checked
B	15-03-16	R.T.	REVISED AS CONSTRUCTION ISSUE	
A	12-01-16	R.T.	AS CONSTRUCTED ISSUE	

LAMBERT & REHBEIN
ENGINEERS • MANAGERS • SCIENTISTS

CBD HOUSE
LEVEL 3, 120 WICKHAM STREET
FORTITUDE VALLEY QLD 4006
P.O. BOX 112 FORTITUDE VALLEY QLD 4006
A.C.N. 010 451 902

TELEPHONE (07) 3250 9000
FACSIMILE (07) 3250 9001
EMAIL mail@lar.net.au



Project: **PROPOSED RESIDENTIAL SUBDIVISION**
58-98 DONALD ROAD
REDLAND BAY - STAGE 5

Title: **SEWERAGE AS CONSTRUCTED PLAN - SHEET 2 OF 2**

Client: **Harridan Pty Ltd**

Drafter: R.T.
Checked: D.L.
Designer: R.T.
Approved: A. PEZZUTTI
RPEQ No: 6382
Scale: AS SHOWN
Date: DEC 2015

Sheet Size	Drawing No.
A1	B02553-C551
A	B

THIS DESIGN AND DRAWING IS COPYRIGHT. NO PART OF THIS DRAWING MAY BE REPRODUCED, STORED IN A RETRIEVAL SYSTEM OR TRANSMITTED IN ANY FORM WITHOUT THE WRITTEN PERMISSION OF LAMBERT AND REHBEIN PTY LTD